



GT46/37/113

**ROAD TRAFFIC REGULATION ACT 1984 – SECTIONS 64 AND 65  
AUTHORISATION OF TRAFFIC SIGNS AND SPECIAL DIRECTIONS**

The Secretary of State for Transport, in exercise of her powers under Sections 64 and 65 of the Road Traffic Regulation Act 1984, and of all other powers enabling her in that behalf, for the purpose of assisting the free flow of vehicular traffic at the junction of Catford Road and Rushey Green, for which Transport for London is the traffic authority, hereby:-

1. authorises the placing within the vicinity of the site marked circled in blue on the attached plan numbered GT46/37/113(Pt4)-7 of a traffic sign consisting of a road marking (hereinafter referred to as “the authorised marking”) conforming as to size, colour and character with those shown in diagrams 1043 and 1044 in Schedule 6 to the Traffic Signs Regulations 2002 (Part I of SI 2002/3113, “the 2002 Regulations”), save that the overall shape of the authorised marking shall be as that shown in yellow on the said plan; and
2. directs, without prejudice to any statutory provision to the like effect, that it is a condition of this authorisation that the placing of the authorised marking at or near the said site shall continue to have effect only until such day as may be appointed by one month’s notice given by the Secretary of State in writing to the traffic authority for the removal or alteration of the authorised marking and on that day the said authorisation shall, without prejudice to the giving of any further authorisation or direction, cease to have effect.


Section 36 of the Road Traffic Act 1988 shall apply to the authorised marking as it applies to the marking shown in diagram 1043 in Schedule 6 to the 2002 Regulations.



GT46/37/113

The provisions of Regulations 12 and 31 of the 2002 Regulations shall apply to the authorised marking in the same manner as they apply to the marking shown in the said diagram 1043.

Dated *16 May* .....2008  
Signed by authority of the Secretary of State

 





.....  
A Grade 7 Official of the Department for Transport



This map is reproduced from Ordnance Survey material with the permission of the Controller of Her Majesty's Stationery Office.  
 © Crown copyright  
 Unauthorised reproduction infringes Crown copyright and may lead to prosecution or civil proceedings.  
 (GLA) 10002379/2009.

Department for Transport

KEY  
 Date 8 May 2008  
 No. 137/11866-140-7

-  EXISTING DOUBLE RED LINES
-  BUS LANE
-  EXISTING YELLOW BOX JUNCTION
-  PROPOSED YELLOW BOX JUNCTION



**Street Management Services**

Windsor House  
 42-50 Victoria Street  
 LONDON SW1H 0TL  
 Telephone 020 7343 5000

TFL	Revisions	Date	Rev.	Init.
NOTES				
Amendments to yellow box		4/4/08	A	RP

designed				
drawn / traced	RP		APR '08	
checked	HKA		MAY '08	
approved				

scale as shown Original Sheet Size A3  
 PROJECT  
 CATFORD ROAD JUNCTION WITH RUSHEY GREEN  
 REVISION OF YELLOW BOX JUNCTIONS


Drawing Status:  
 TFL DWG No. LEWI\_637\_02 Rev. A

**Existing Road Markings**




YBJ Boundary line thickness: 200mm  
 YBJ Hatch line thickness: 150mm

**Revised Road Markings**

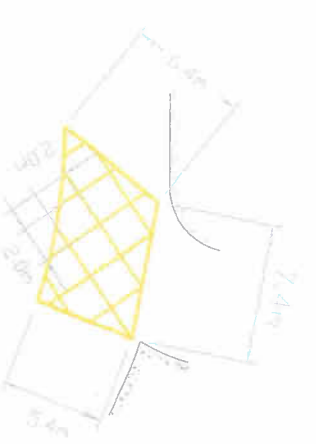

YBJ Boundary line thickness: 200mm  
 YBJ Hatch line thickness: 150mm

Scale 1:400

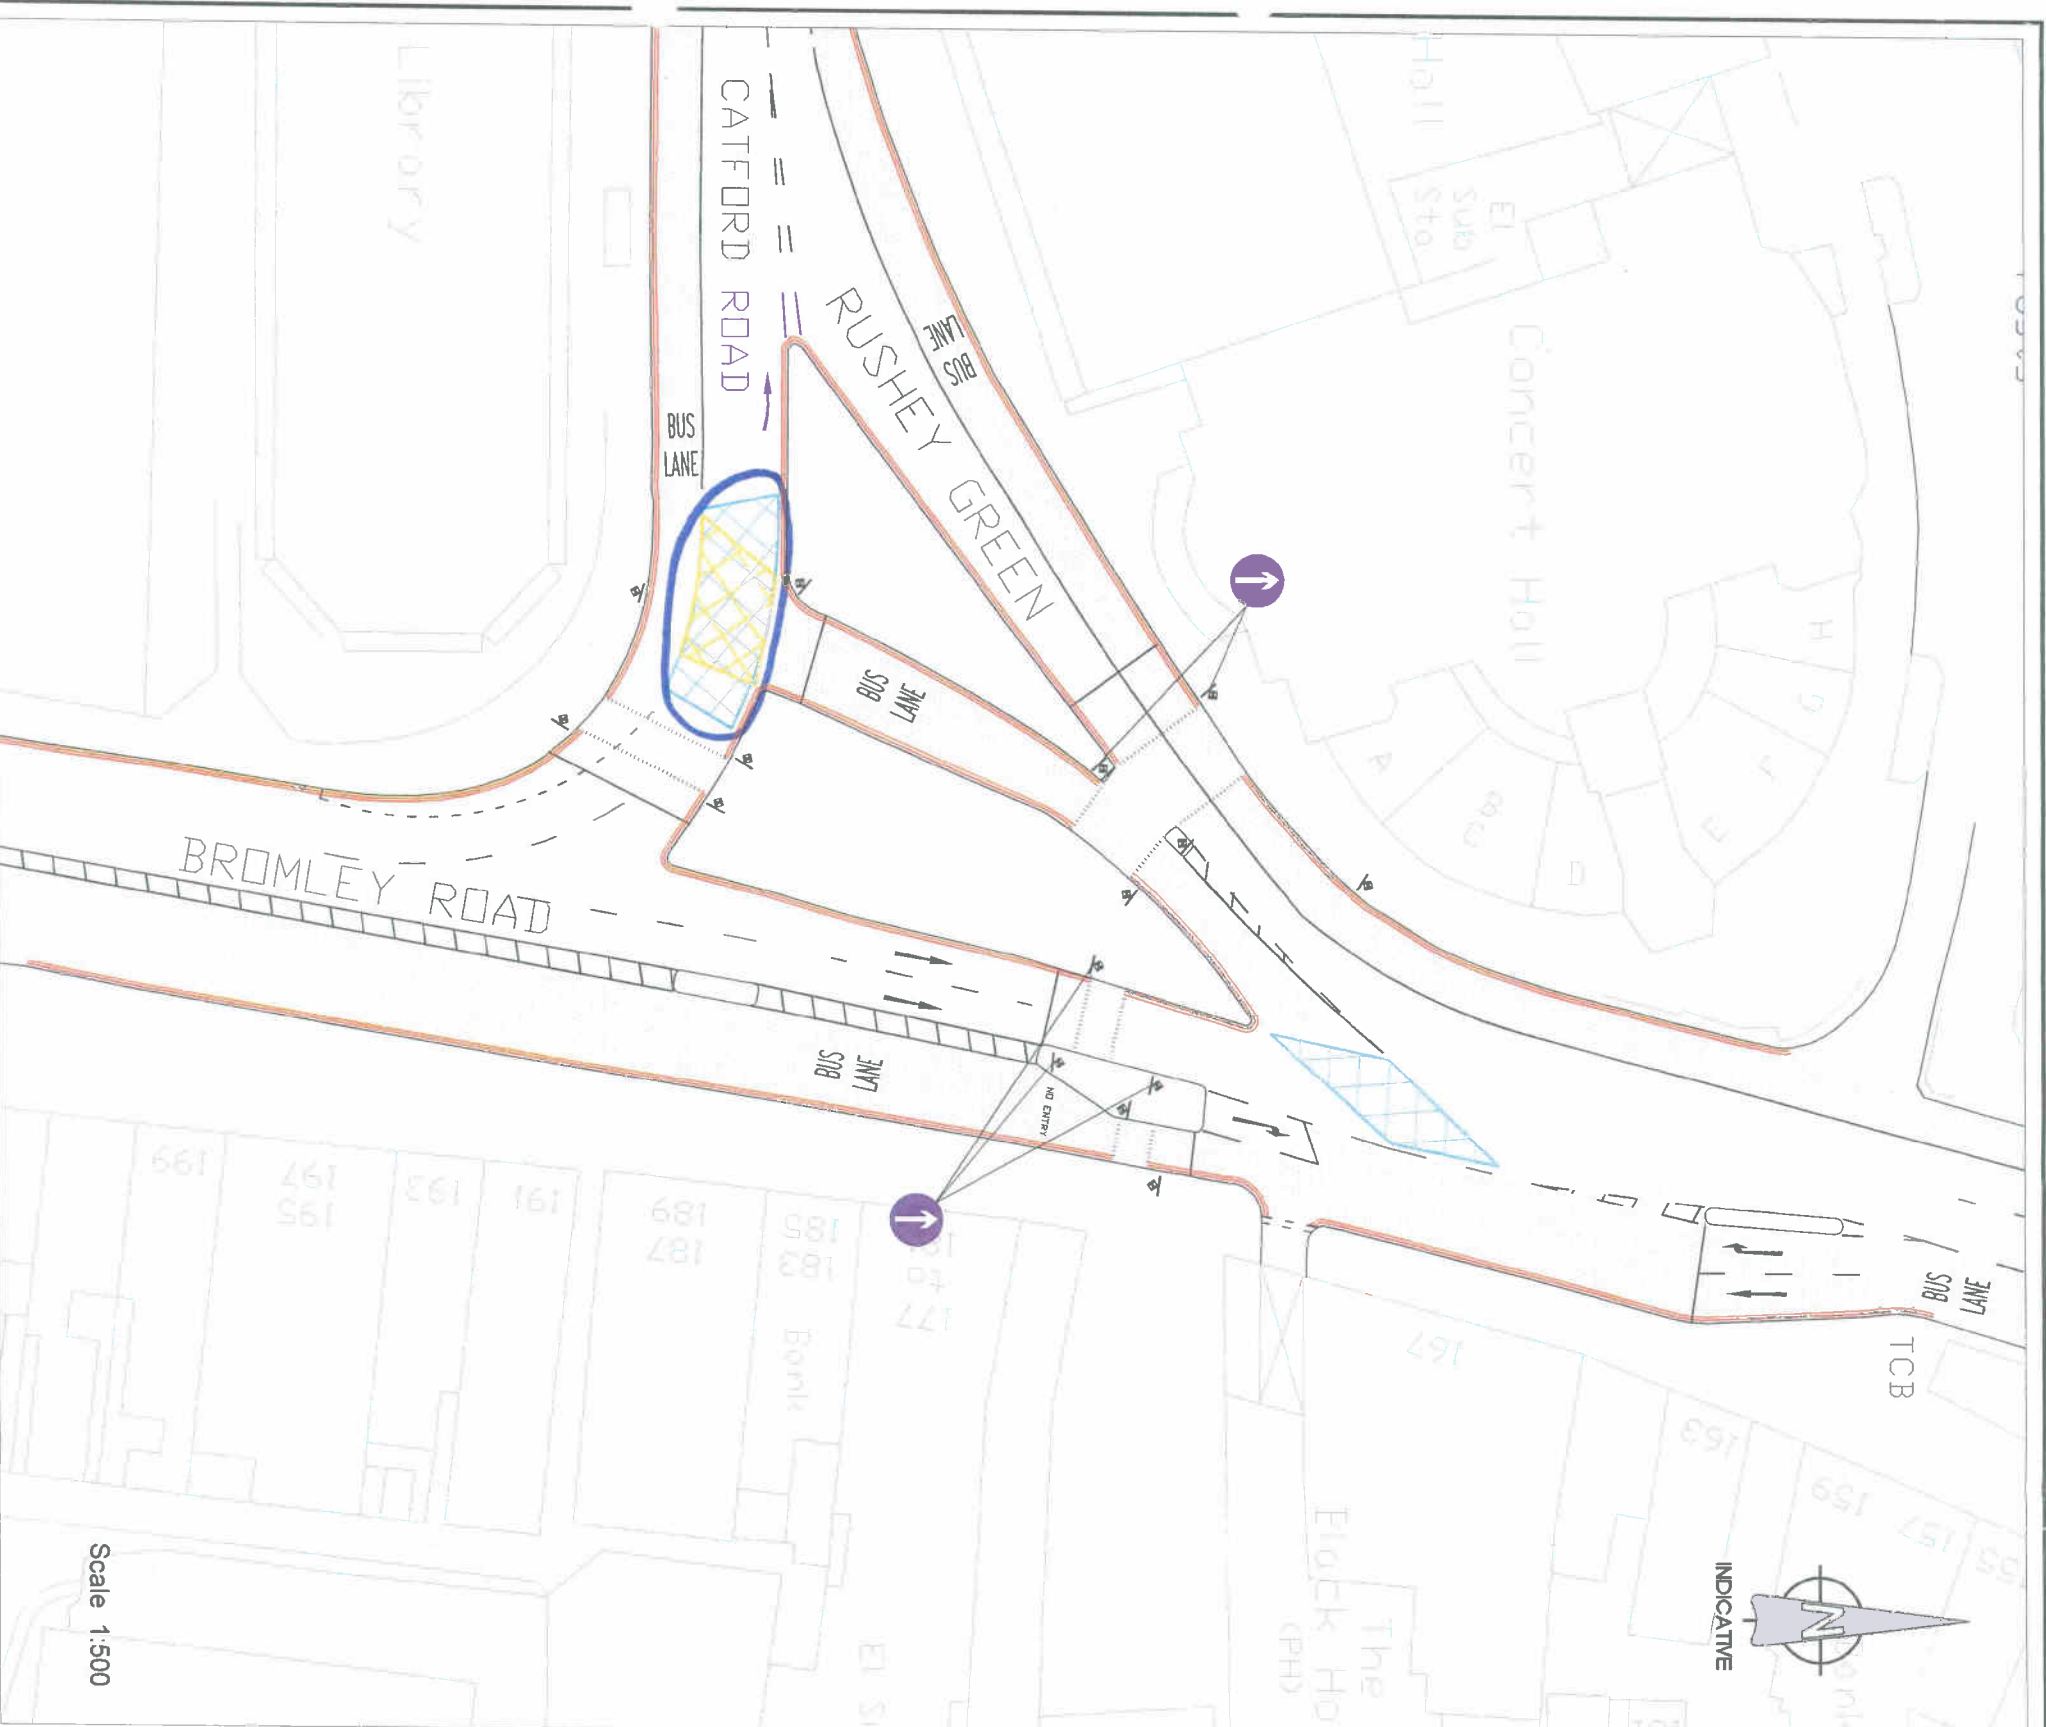

Scale 1:500